



Law Offices of Richard G. Di Girolamo  
424 Broadway  
Somerville, MA 02145

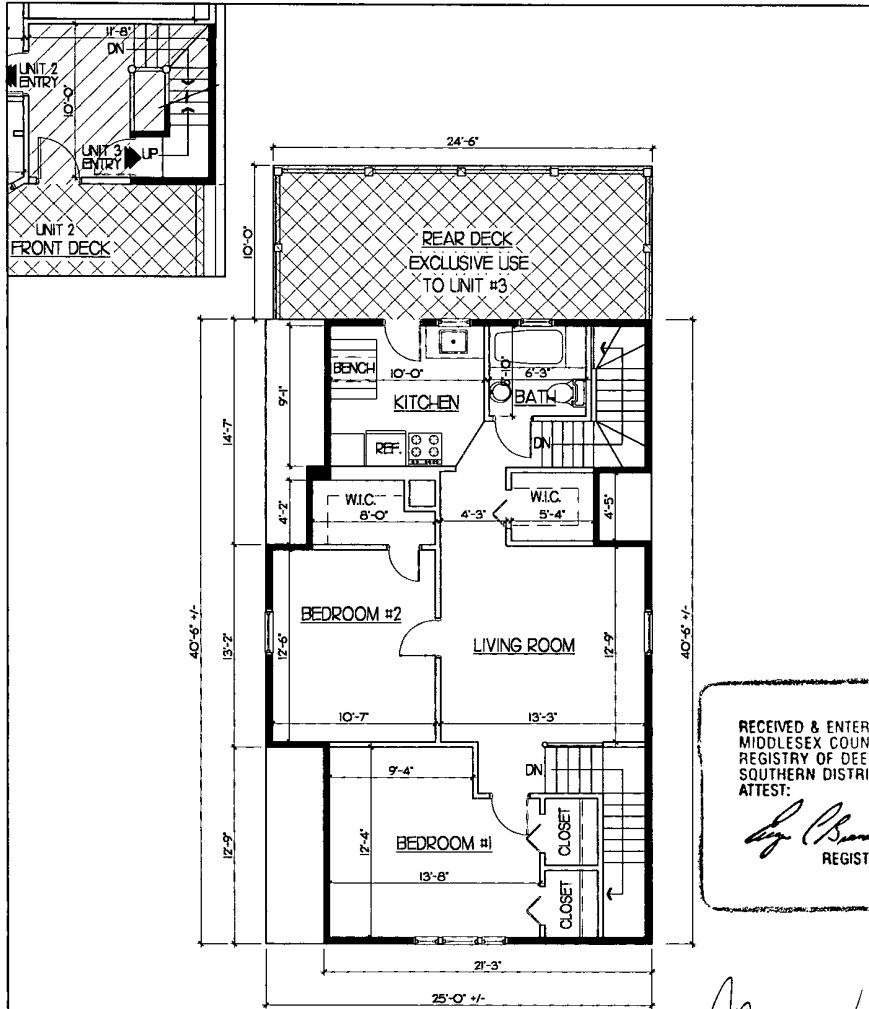

RECEIVED & ENTERED  
MIDDLESEX COUNTY  
REGISTRY OF DEEDS  
SOUTHERN DISTRICT  
ATTEST:  
*[Signature]*  
REGISTER

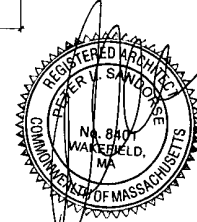

PREPARED BY:  
SFG STUDIOS  
6 FOSTER STREET, SUITE 8  
WAKEFIELD, MA 01880  
781-213-3442

THIRD FLOOR PLAN  
1012 GSF

884 NSF THIS FLOOR  
7 NSF FRONT ENTRY - SECOND FLOOR  
891 NSF TOTAL UNIT FLOOR AREA

245 SF EXCLUSIVE USE AREA(S) - REAR DECK

UP-3.0	THE 18-20 GARRISON AVENUE CONDOMINIUM SOMERVILLE, MA	UNIT FLOOR PLAN: UNIT 3 THIRD FLOOR PLAN 20 GARRISON AVENUE	I HEREBY CERTIFY THAT THIS PLAN HAS BEEN PREPARED IN CONFORMITY WITH THE RULES AND REGULATIONS OF THE REGISTRY OF DEEDS OF THE COMMONWEALTH OF MASSACHUSETTS.
 CALLED NORTH DRAWN BY: SFG DATE: 09-15-2003	<p>LEGEND</p> <ul style="list-style-type: none"> <li> MAIN ENTRANCE</li> <li> COMMON AREA</li> <li> COMMON AREA WITH EXCLUSIVE USE TO UNIT NOTED</li> </ul>		<p>I HEREBY CERTIFY THAT THIS UNIT DEED SHOWS THE UNIT DESIGNATION OF UNIT #3, THIRD FLOOR, AND OF ITS IMMEDIATE ADJOINING UNITS, AND FULLY AND ACCURATELY DEPICTS THE LAYOUT OF UNIT #3, ITS LOCATION, DIMENSIONS, APPROPRIATE AREA, MAIN ENTRANCE AND IMMEDIATE COMMON AREA TO WHICH IT HAS ACCESS, AS BUILT.</p> <p><i>[Signature]</i> 3.15.04 ARCHITECT DATE</p>